


SKY RIDGE ASPEN BUILDING

10103 RIDGEGATE PARKWAY, LONE TREE, CO

SUITE 110
2,963 SF

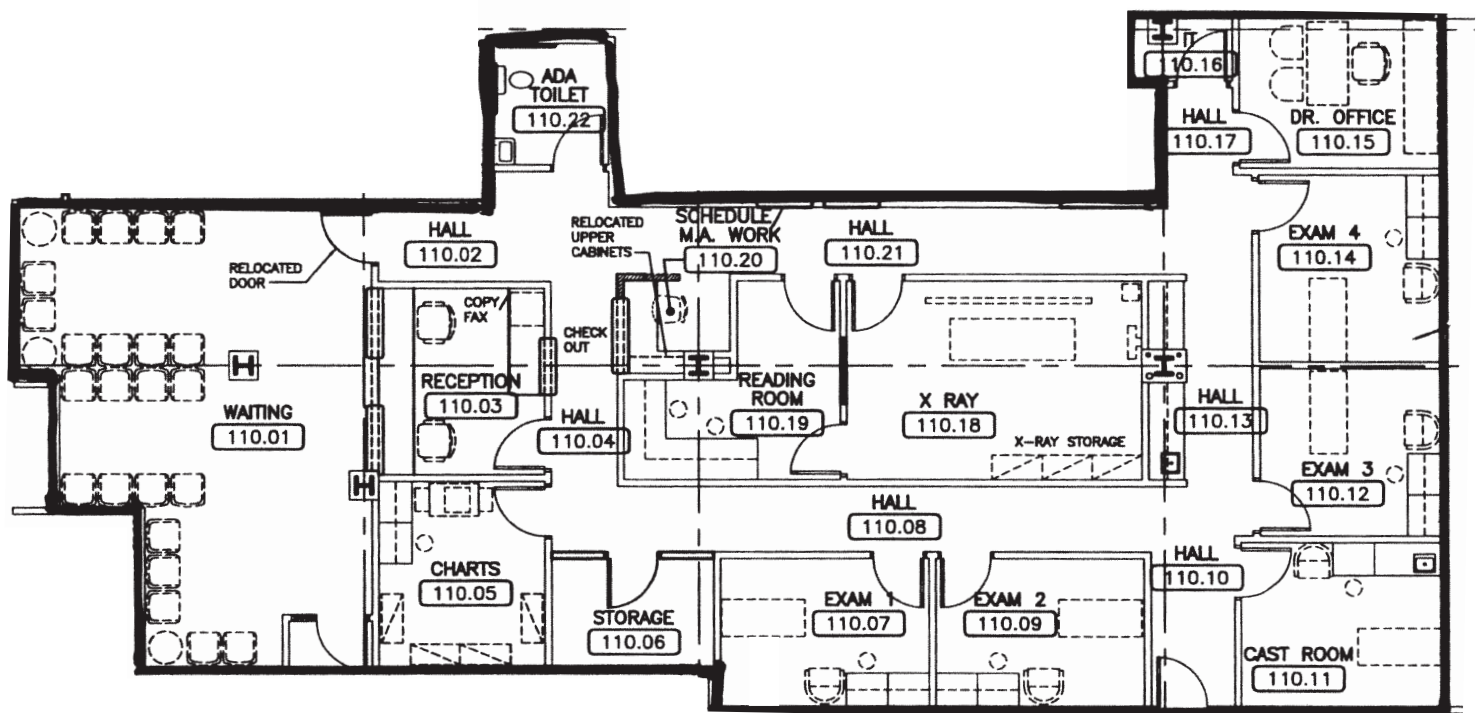

DANN BURKE
+1 720 528 6362
DANN.BURKE@CBRE.COM

STEPHANI GASKINS
+1 720 528 6346
STEPHANI.GASKINS@CBRE.COM

ANNA HEISERMAN
+1 303 583 2099
ANNA.HEISERMAN@CBRE.COM

